

NOTES

-ALL STORMWATER DRAINAGE PIPES ARE RCP, CLASS '2' U.N.O.

-ALL ROOFWATER DRAINAGE PIPES ARE Ø150, PVC CLASS 'B' U.N.O.

REGISTERED CADASTRAL SURVEYOR (QLD) CERTIFICATION

LandPartners Pty Ltd, hereby certify that the horizontal and vertical locations, and dimensions shown on this plan are a true and correct record of the As Constructed information.

[Signature] 4118 23/07/2025

Authorised Delegate Rego No. Date

LandPartners Pty Ltd

Registered Qld Surveyor Corporation

AS CONSTRUCTED CERTIFICATION

I, _____ (Company's representative Name) _____ (Signature)

_____(Date) _____ (RPEQ)

Being a duly representative of:- _____ (Company Name)


Hereby certify that

1. The information contained in this drawing / document is in compliance with approved drawings and design supplied under the terms of the contract.

2. This represents an accurate "As constructed" record of works carried out and accept responsibility for the information contained in this drawing / document.

COORDINATE DATUM NOTE:

HORIZONTAL COORDINATES (E,N) SUPPLIED ARE MAPPING GRID OF AUSTRALIA (MGA), ZONE 56 BASED ON THE UNIVERSAL TRANSVERSE MERCATOR PROJECTION AND THE GEOCENTRIC DATUM OF AUSTRALIA 2020.

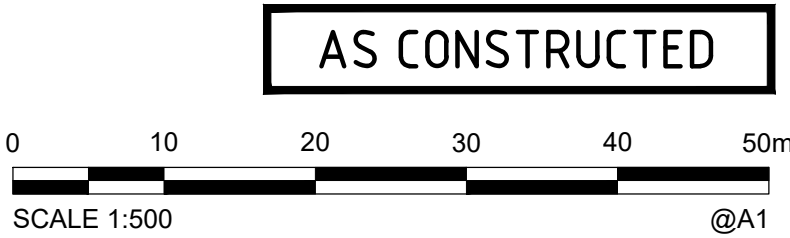

A1																																																																																																																																																																																																																																																																																																																																																																																																																																																																																																																																																																																																																																																																																																																																																																																																																																																																																																																																																																																																																																																																																																																																																																																																																																																																																																																																																																																																																				</
----	--	--	----