
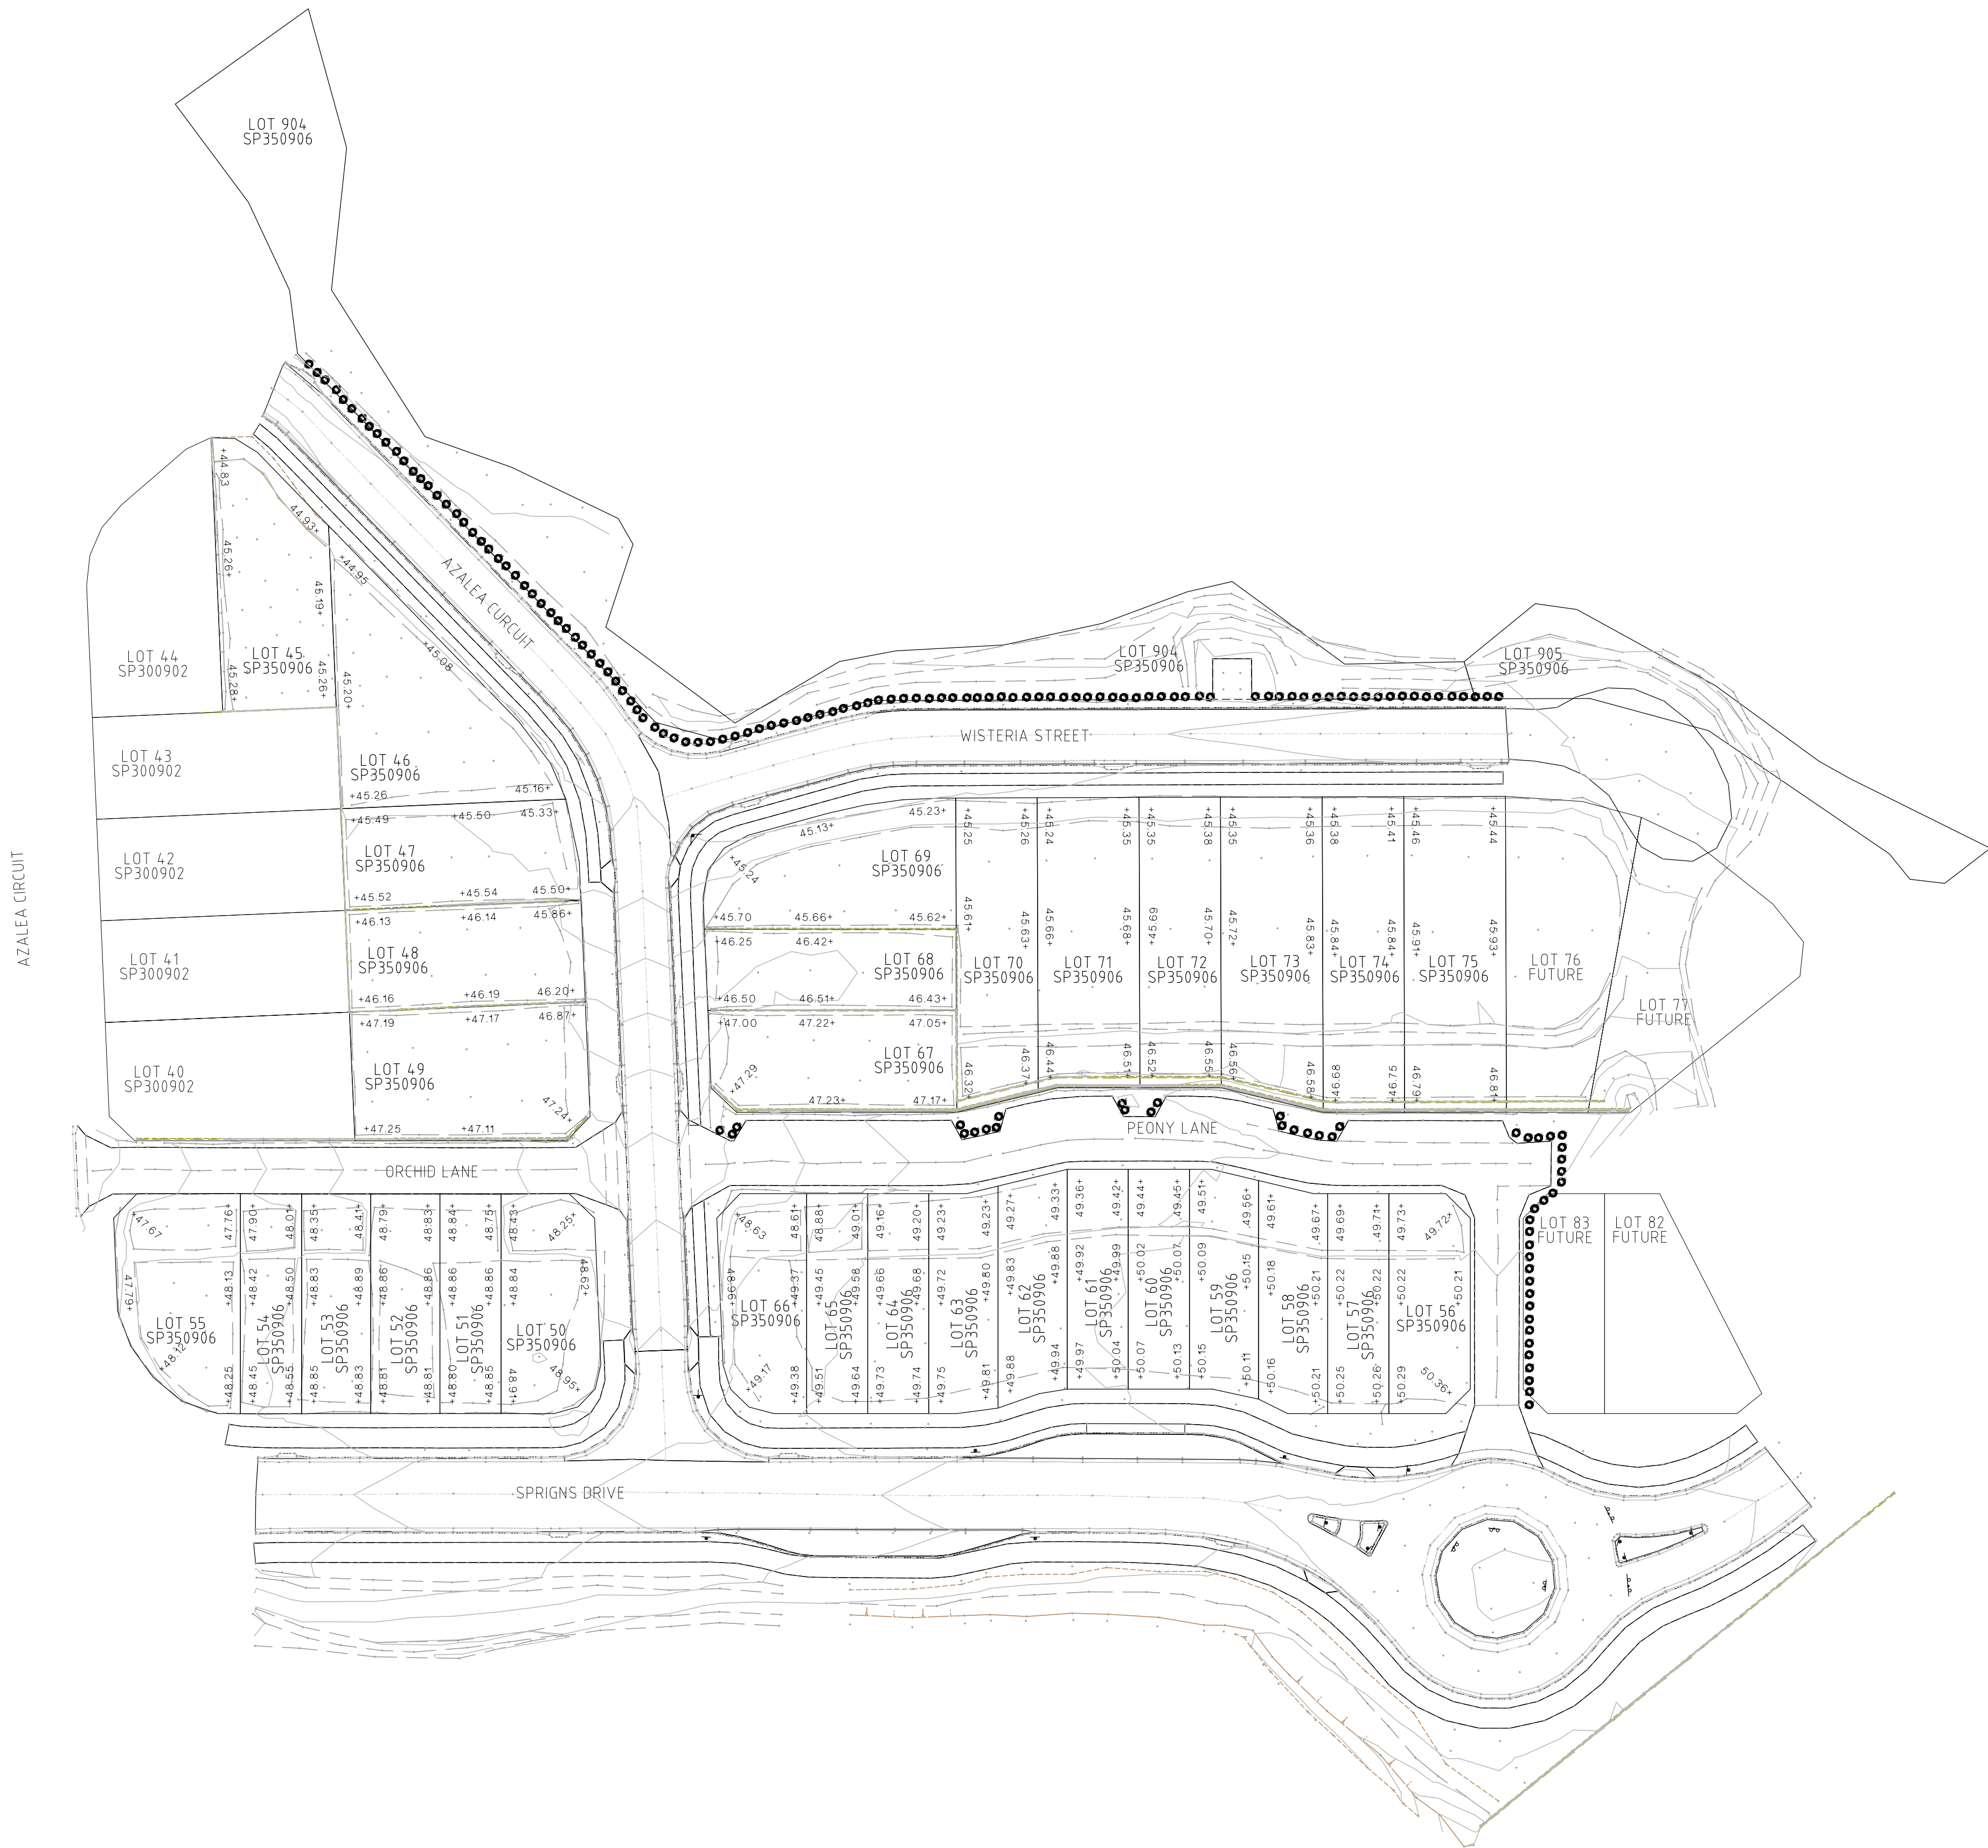


LEGEND

-----	BOTTOM OF WALL
-----	TOP OF WALL
-----	LIP OF KERB
-----	BACK OF KERB
-----	EDGE OF CONCRETE
-----	CONTOURS
-----	CHANGE OF GRADE
-----	BOTTOM OF BANK
-----	TOP OF BANK
-----	CROWN OF ROAD
-----	FENCE
○	BOLLARD (0.7M)
Q	SIGN (N.T.S.)

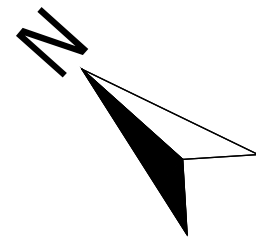

NOTES

- CONTOURS ARE SHOWN AT AN INTERVAL OF 0.5m

REGISTERED CADASTRAL SURVEYOR (QLD) CERTIFICATION

LandPartners Pty Ltd, hereby certify that the horizontal and vertical locations, and dimensions shown on this plan are a true and correct record of the As Constructed information.

 4118 31/07/2025
Authorised Delegate Rego No. Date
LandPartners Pty Ltd
Registered Qld Surveyor Corporation


AS CONSTRUCTED CERTIFICATION

I, _____ (Company's representative Name) _____ (Signature)
_____, _____ (Date) _____ (RPEQ)
Being a duly representative of:- _____ (Company Name)
Hereby certify that
1. The information contained in this drawing / document is in compliance with approved drawings and design supplied under the terms of the contract.
2. This represents an accurate "As constructed" record of works carried out and accept responsibility for the information contained in this drawing / document.

COORDINATE DATUM NOTE:

HORIZONTAL COORDINATES (E,N) SUPPLIED ARE MAPPING GRID OF AUSTRALIA (MGA), ZONE 56 BASED ON THE UNIVERSAL TRANSVERSE MERCATOR PROJECTION AND THE GEOCENTRIC DATUM OF AUSTRALIA 2020.

AS CONSTRUCTED

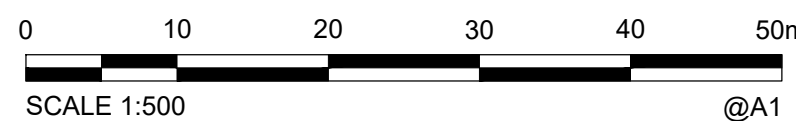

A1

2	31/07/2025	ADDITION OF SIGNS	MJK	PB	PB
1	22/07/2025	1	MJK	PB	PB
INDEX	DATE	REVISIONS	DRAWN	CHECKED	PASSED

DRAWN	MJK	31/07/2025
CHECKED	PB	31/07/2025
PASSED	PB	31/07/2025
INITIALS	DATE	

MNG
LANDPARTNERS

Perth | Brisbane | Melbourne | Sydney | Broome | South West WA

Brisbane Office
Level 1
18 Little Cribb Street
Milton QLD 4064
p: (07) 3842 1000
e: brisbane@mnglandpartners.com.au
w: www.landpartners.com.au



IPSWICH CITY COUNCIL

DEEBING SPRINGS - STAGE 1D
AS-CONSTRUCTED TOPOGRAPHY
7877/2008/MAMC/A

SCALE 1500

SHEET 1 OF 1 SHEETS

DRAWING NO.

WC008495-01D-71-2