
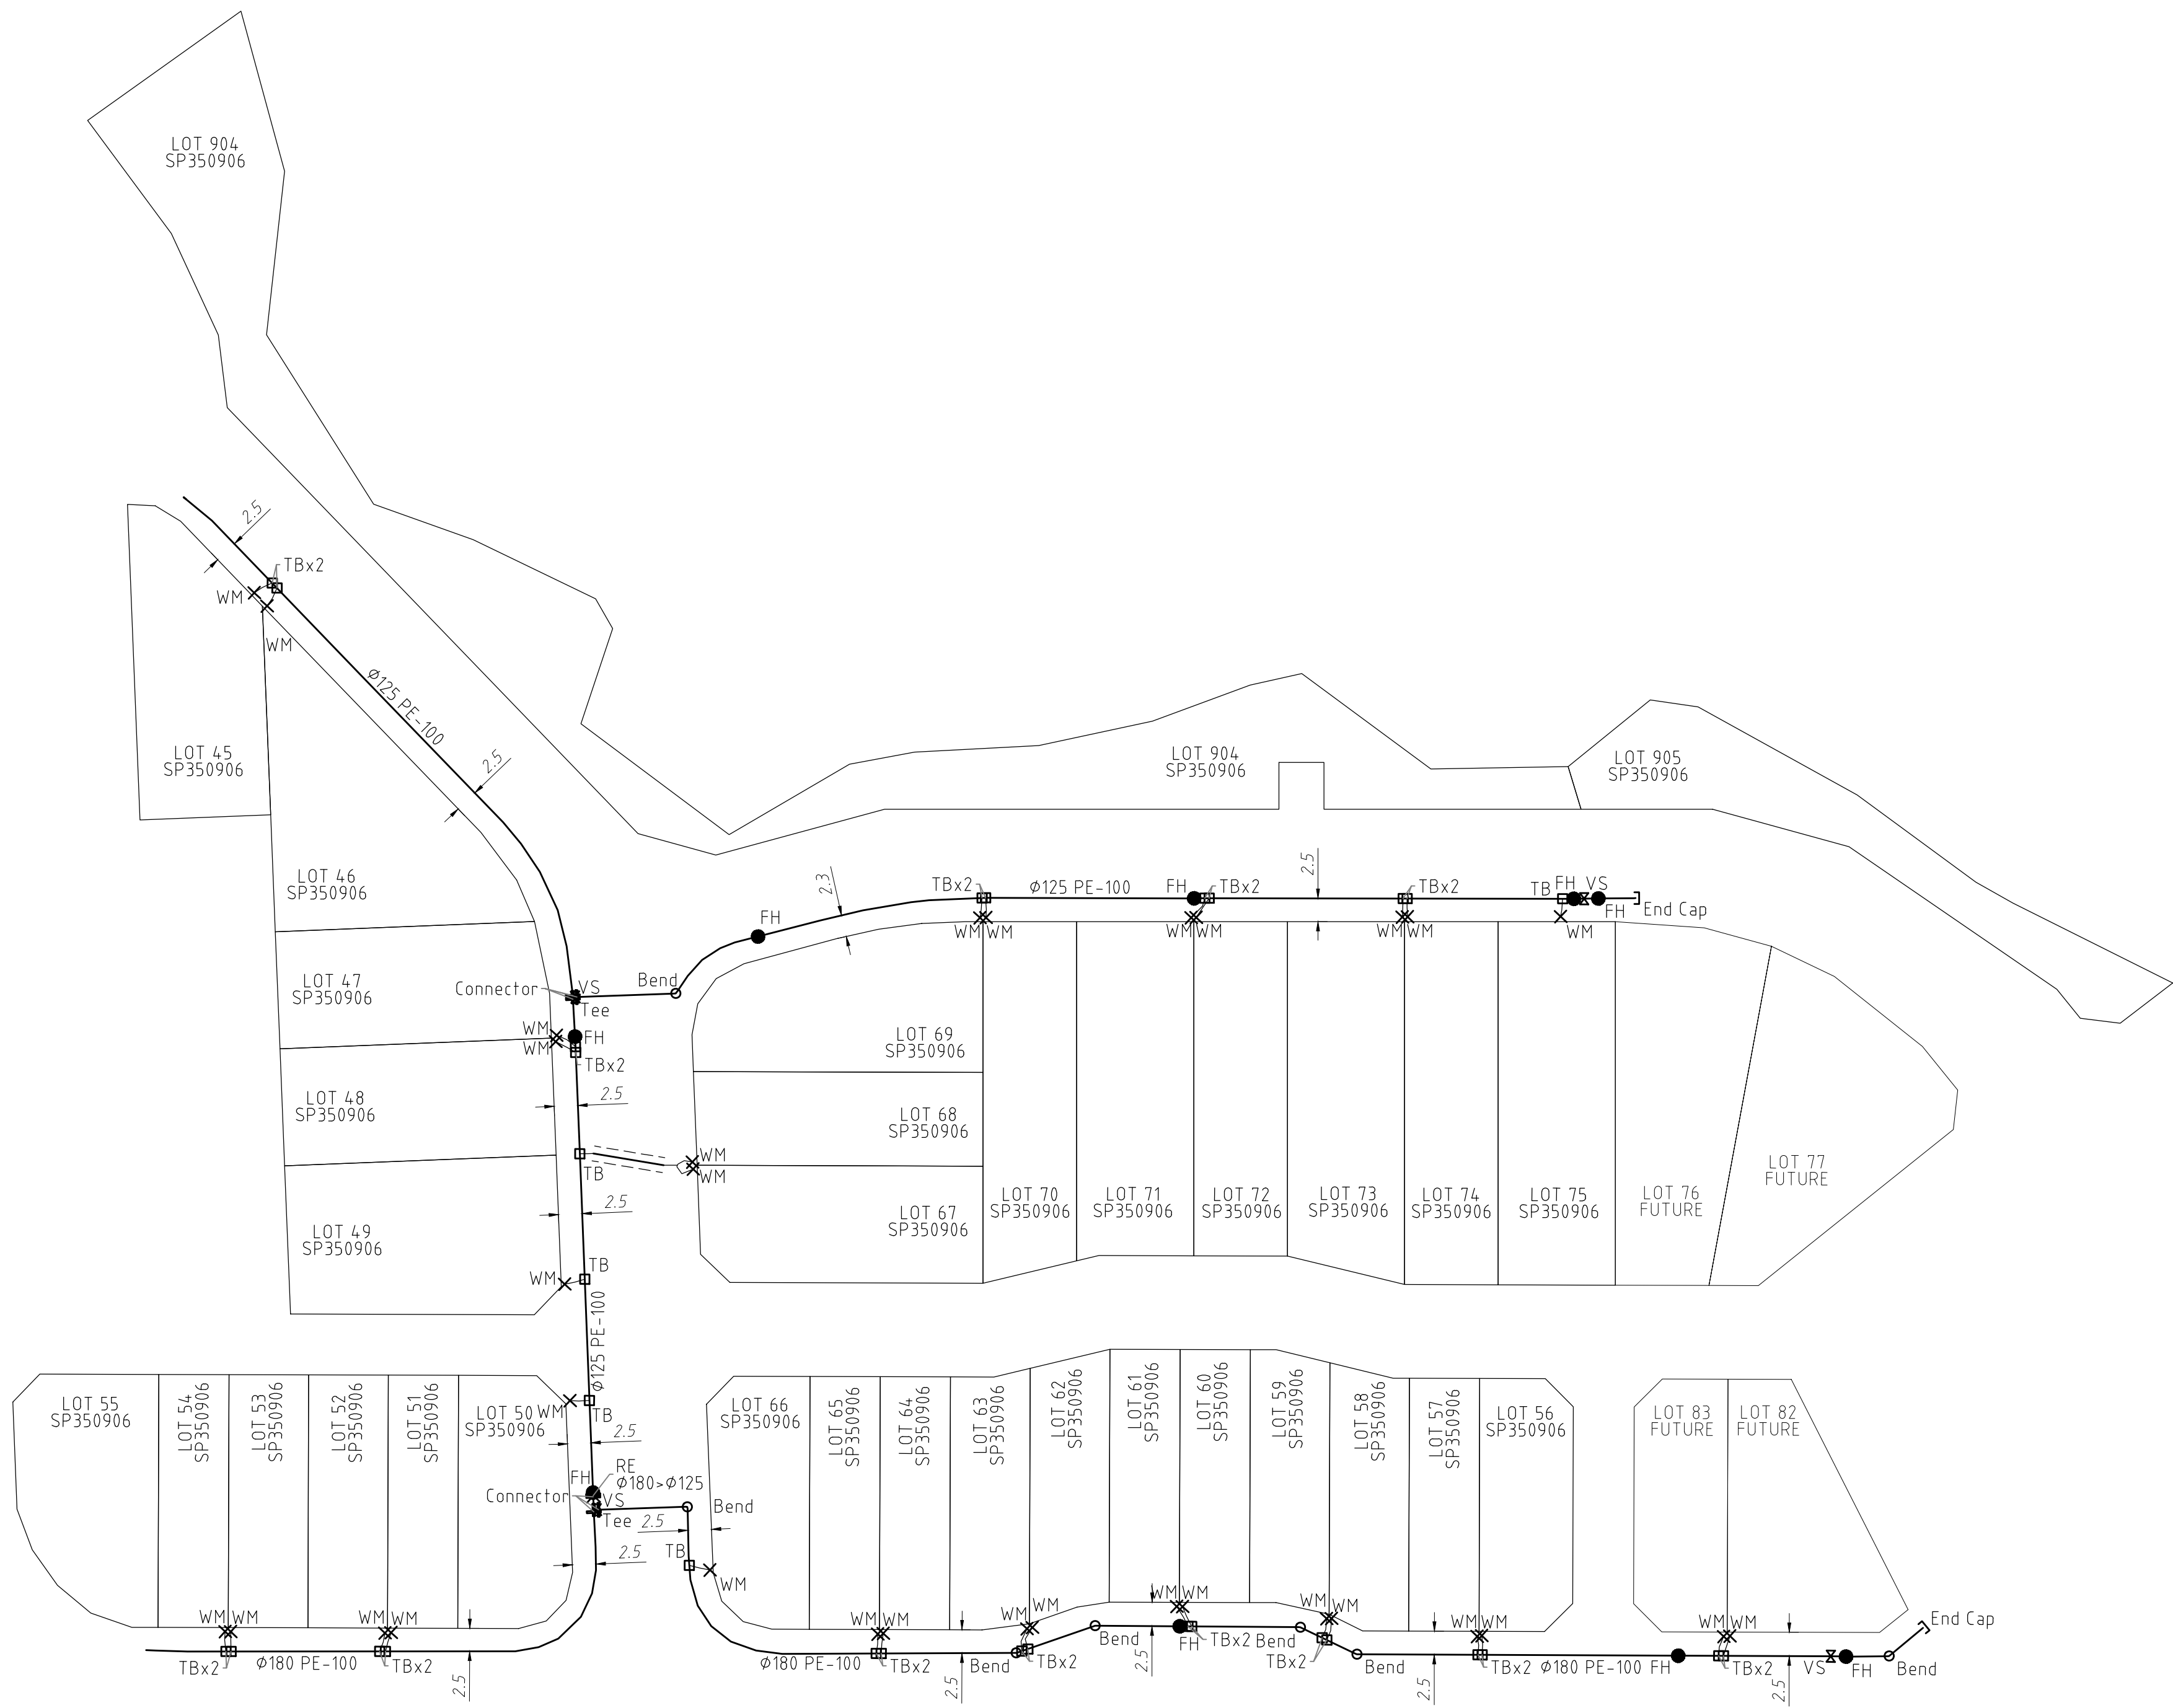


LEGEND

- (FH) FIRE HYDRANT
- ⋈ (VS) STOP VALVE/(FP) FLUSHING POINT
- ✕ (VA) SCOUR ASSEMBLY
- (RT) READY TAP/(TB) TAPPING BAND
- × (WM) WATER METER (SEQ 20φ)
- └ END CAP
- ├ TEE
- ^ REDUCER
- BEND
- DI CL WATER MAIN CROSSING
- ===== CONDUIT/CROSSING
- EXISTING WATER

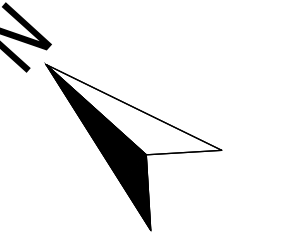

NOTES

- ALL WATER MAIN PIPES ARE PE-100, PN16 U.N.O.
- ALL FIRE HYDRANTS ARE φ100 SPRING U.N.O.
- ALL SERVICE CROSSING CONDUITS ARE φ100 uPVC PN12 U.N.O.
- ALL WATER METERS ARE φ20 U.N.O.

REGISTERED CADASTRAL SURVEYOR (OLD) CERTIFICATION

LandPartners Pty Ltd, hereby certify that the vertical and horizontal locations and dimensions shown on this plan are a true and correct record and were located by survey.


 4118 15/07/2025
Authorised Delegate Rego No. Date
LandPartners Pty Ltd
Registered Qld Surveyor Corporation

ENGINEER'S CERTIFICATION

- I,, hereby certify that:
- The information contained in this drawing / document is in compliance with approved drawings and design.
 - The new water and sewerage works defined by this drawing have been designed and constructed in accordance with the SEQ Code.
 - This represents an accurate record of as-constructed works.
 - I accept responsibility for the information contained in this drawing / document.

RPEQ (signature) RPEQ No. Date:

AS CONSTRUCTED

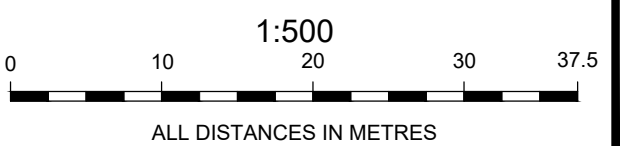

A1

INDEX	DATE	REVISIONS	DRAWN	CHECKED	PASSED
1	15/07/2025	INITIAL ISSUE	MJK	PB	PB

INITIALS	DATE
DRAWN MJK	15/07/2025
CHECKED PB	15/07/2025
PASSED PB	15/07/2025

MNG
LANDPARTNERS

Brisbane Office
Level 1
18 Little Cribb Street
Milton QLD 4064
p: (07) 3842 1000
e: brisbane@mnglandpartners.com.au
w: www.landpartners.com.au
Perth | Brisbane | Melbourne | Sydney | Broome | South West WA



Queensland Urban Utilities

DEEBING SPRINGS - STAGE 1D
AS-CONSTRUCTED WATER
19-PNT42783

SCALE 1:500
SHEET 1 OF 1 SHEETS
DRAWING NO.
WC008495-01D-67-1