


Consulting Engineers Certification
 I, Mitchell GASSMAN, hereby certify that the As Constructed information shown on this plan is a true and correct record of the sizes, types, materials, classes etc., and it corresponds with the relevant approved Engineering Drawings.
 Signed: *[Signature]* RPEQ No 16939 Dated: 22/02/2026

Registered Surveyor's Certification
 I, Anthony GERAGHTY, hereby certify that the horizontal and vertical locations, and dimensions shown on this plan are a true and correct record of the As Constructed information.
 Signed: *[Signature]* Reg. No 3222 Dated: 22/02/2026

FEATURE LEGEND

- SW MANHOLE
- GULLY PIT
- DRAINWAY
- FIELD INLET
- HEADWALL
- TOP/BOTTOM OF BANK
- RETAINING WALL
- SURFACE LEVEL
- 0.25m CONTOUR

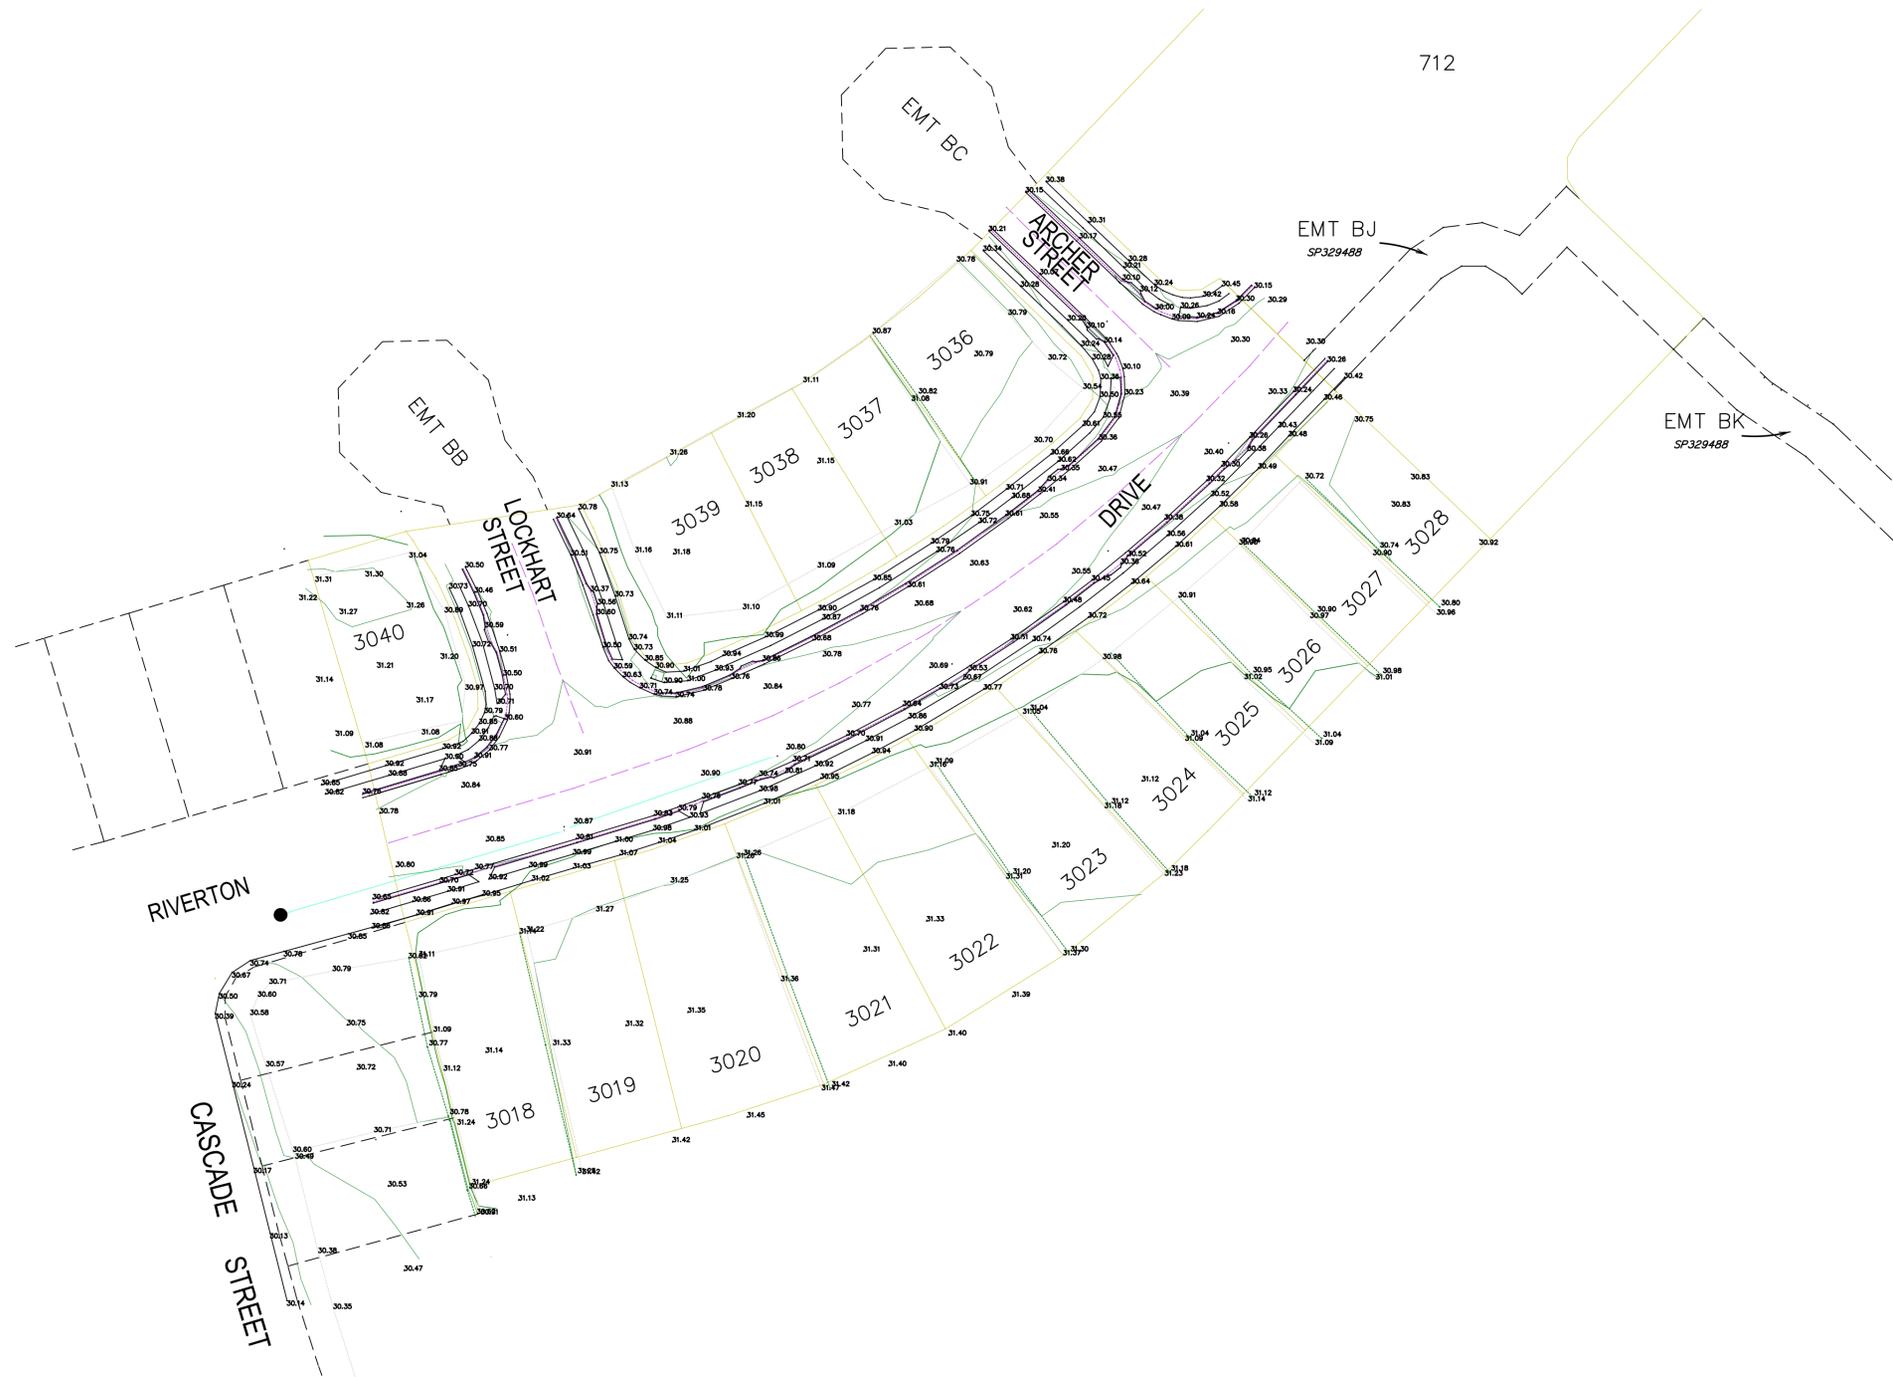

Scale 1:500 - Lengths are in Metres.
 0 5 10 15 20 25 30 35 40



planning | environment | landscape | engineering | survey
 T: 3807 3333 | F: 3287 6461 | www.gassman.com.au
 Gold Coast | 76 Business Street, Yatala QLD | PO Box 392, Beenleigh 4207

Issue	Date	Description	SH	TH
10-2025		ORIGINAL ISSUE	SH	TH
			DRN	CHK

Project: **RIVERTON**
 Cusack Lane , Jimboomba

Client: **AVID PROPERTY GROUP**

©2012 Gassman Development Perspectives
 All rights reserved. No part of this document may be reproduced or transmitted in any form or by any means, electronic, mechanical, photocopying, recording, or otherwise, without the written permission of Gassman Development Perspectives.

Scale at A1: **1:500**
 Date: **22-02-26**
 Surveyed: **TH**
 Drawn: **AR**
 Checked: **TH**

Drawing Title:
**AS CONSTRUCTED PLAN
 STAGE 3Aii EARTHWORKS**

Drawing No: **5544 500 STG 3Aii - EARTHWORKS** Revision No: