

Consulting Engineer's Certification

I, Mitchell GASSMAN, hereby certify that the As Constructed information shown on this plan is a true and correct record of the sizes, types, materials, classes etc., and it corresponds with the relevant approved Engineering Drawings.


Signed..... RPEQ No 16939 Dated.....

Registered Surveyor's Certification

I, Anthony GERAGHTY, hereby certify that the horizontal and vertical locations, and dimensions shown on this plan are a true and correct record of the As Constructed information.

Signed.....Reg. No 3222 Dated.....

- FEATURE LEGEND
- MANHOLE
 - GULLY PIT
 - DRAINWAY
 - FIELD INLET
 - HEADWALL
 - BLANKED OFF END
 - STORMWATER PIPE
 - EXISTING MANHOLE
 - EXISTING HEADWALL
 - EXISTING GULLY PIT
 - EXISTING DRAINWAY
 - EXISTING STORMWATER PIPE

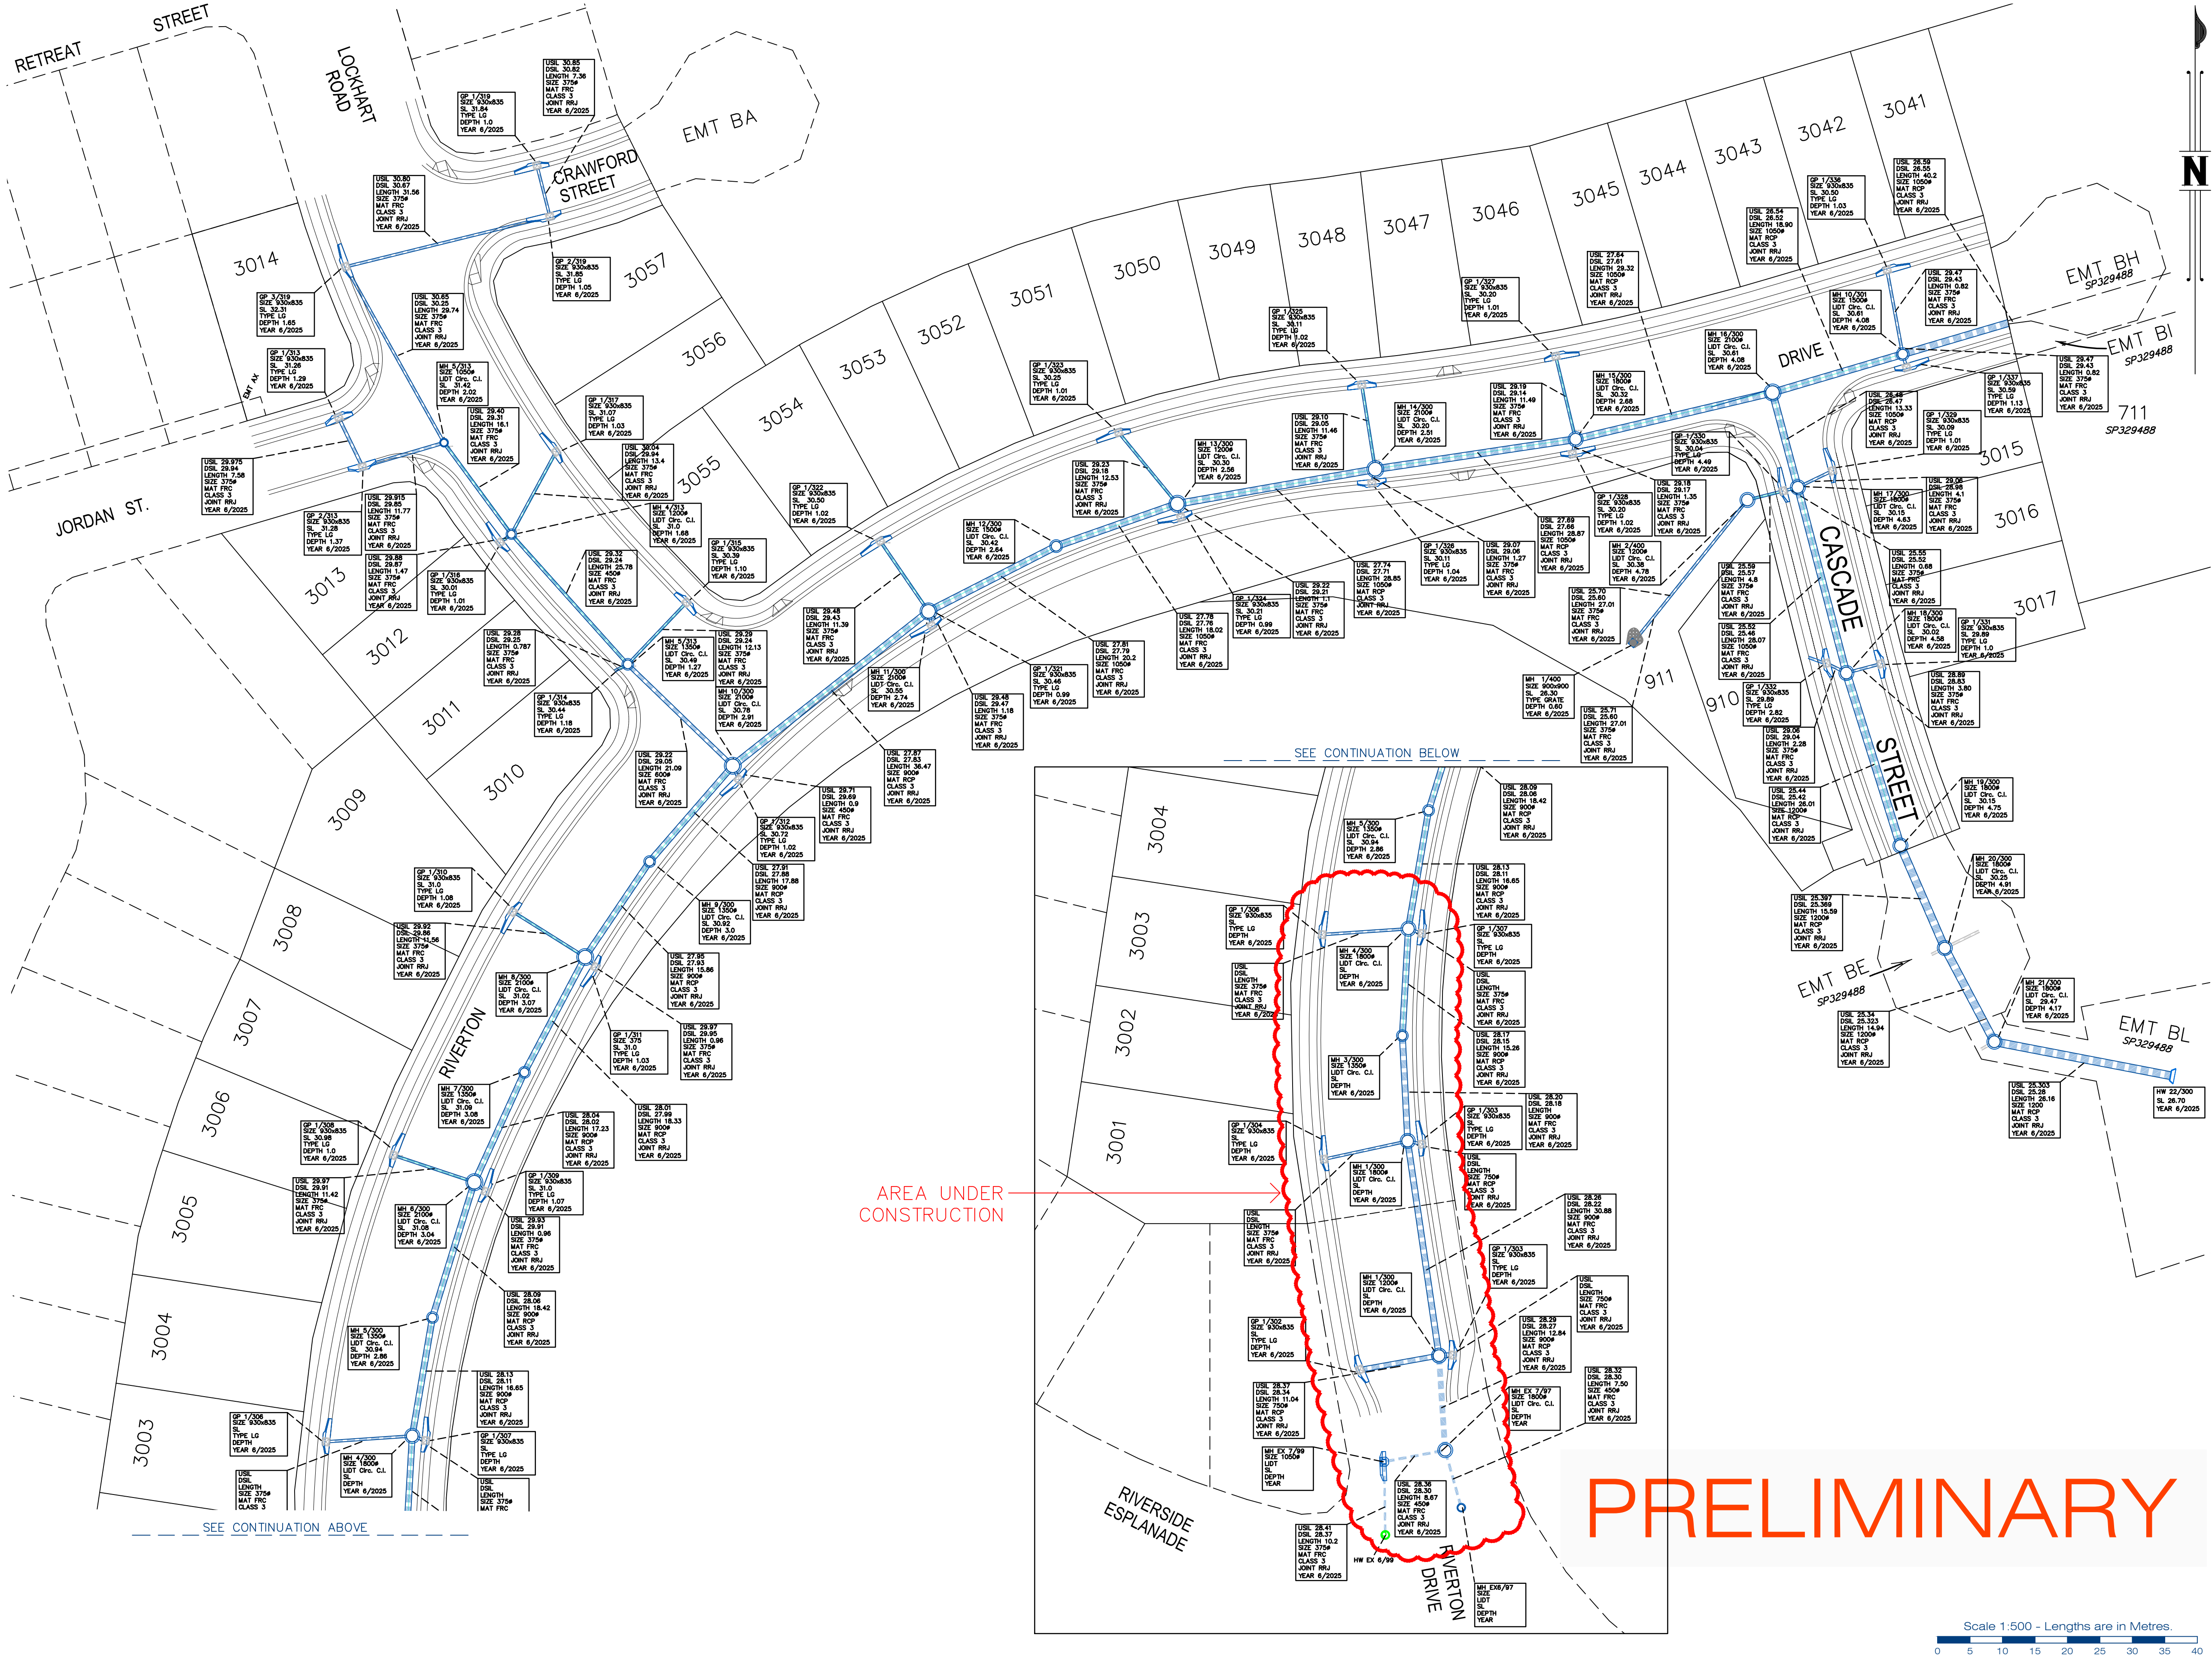

PRELIMINARY

Issue	Date	Description	SH	TH	CHK
-	27-11-2025	PRELIMINARY ISSUE	SH	TH	

Project:

RIVERTON
Cusack Lane , Jimboomba

Client:

A.V.JENNINGS

©2012 Gassman Development Perspectives
All rights reserved. No part of this document may be reproduced or transmitted in any form or by any means, electronic, mechanical, photocopying, recording, or otherwise, without the written permission of Gassman Development Perspectives.

Scale at A1:

Date: **1:500**

Surveyed: **27-11-25**

Drawn: **TH**

Checked: **SH**

Drawing Title:

**AS CONSTRUCTED PLAN
STAGE 3aI STORMWATER**

Drawing No: **5544 500 STG 3aI - STORMWATER**

Revision No: